NOT USED
32 DETAIL
SCALE: N.T.S

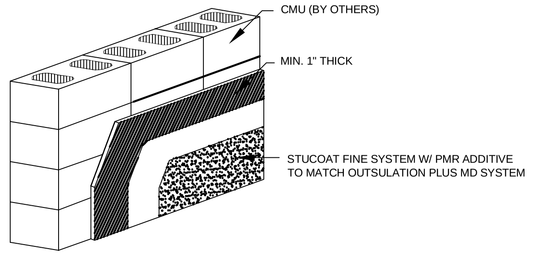

DRYVIT STUCOAT OVER CMU
28 DETAIL
SCALE: N.T.S

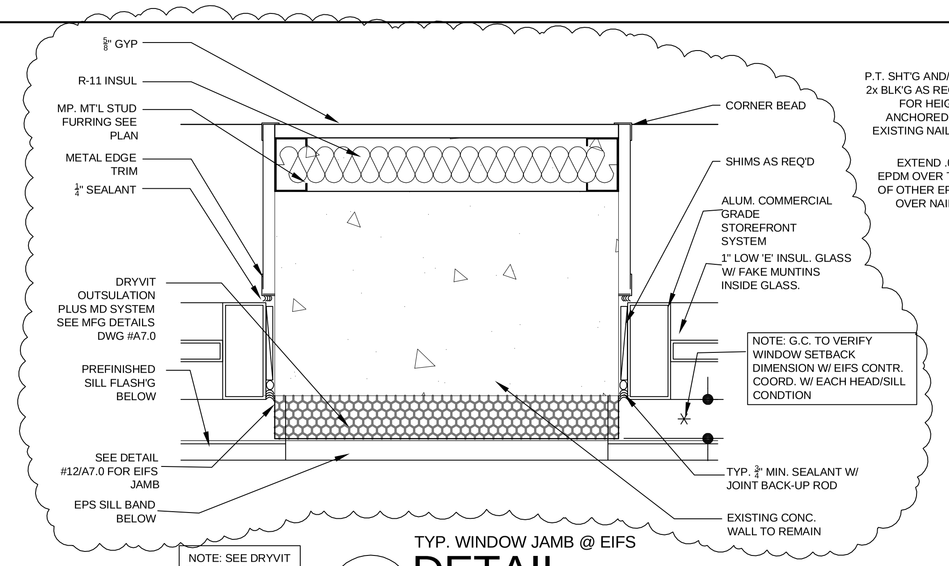

NOTE: SEE DRYVIT TYP WINDOW JAMB & FLASH'G DETAILS ON A7.0 FOR FURTHER NOTES

TYP. WINDOW JAMB @ EIFS
24 DETAIL
SCALE: 3" = 1'-0"

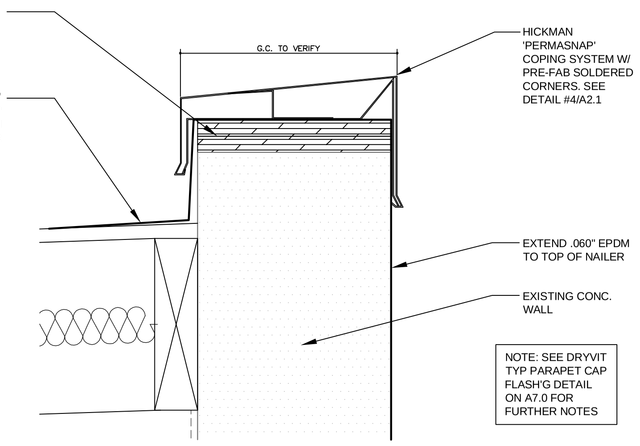

NOTE: SEE DRYVIT TYP PARAPET CAP FLASH'G DETAIL ON A7.0 FOR FURTHER NOTES

COPING @ MEZZANINE
20 DETAIL
SCALE: 3" = 1'-0"

NOT USED
31 DETAIL
SCALE: N.T.S

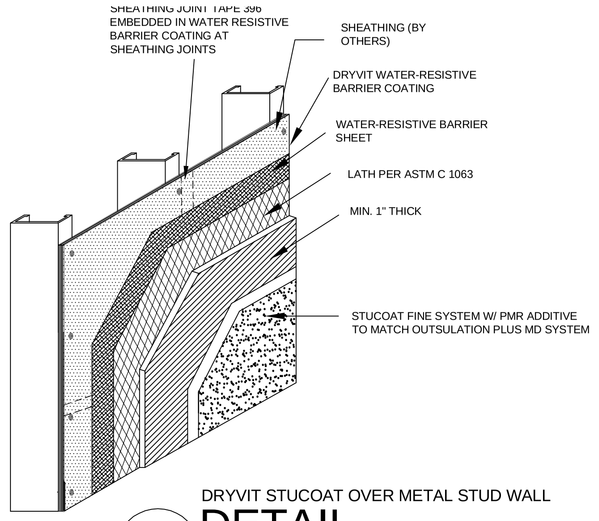

DRYVIT STUCOAT OVER METAL STUD WALL
27 DETAIL
SCALE: N.T.S

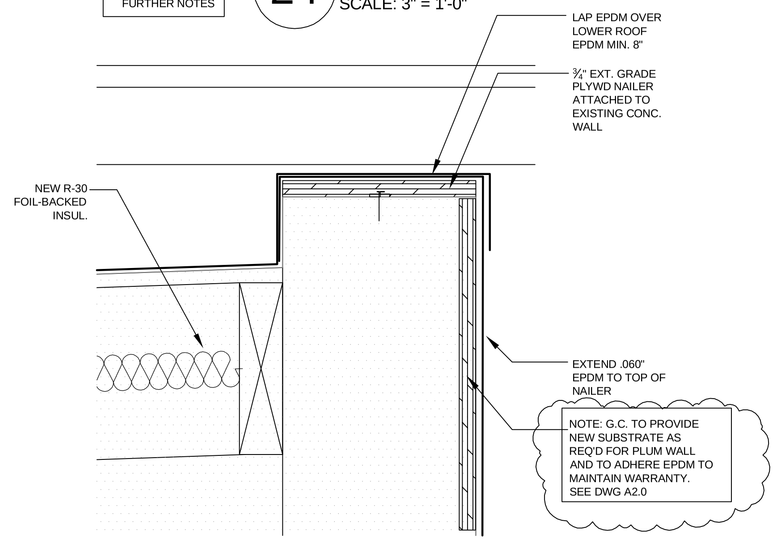

EPDM CURB @ RTU'S
23 DETAIL
SCALE: 3" = 1'-0"

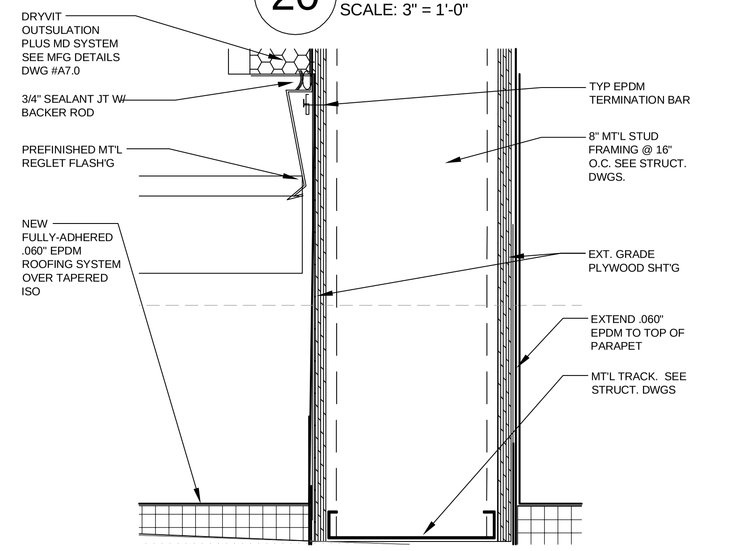

ENTRY TOWER DETAIL
19 DETAIL
SCALE: N.T.S

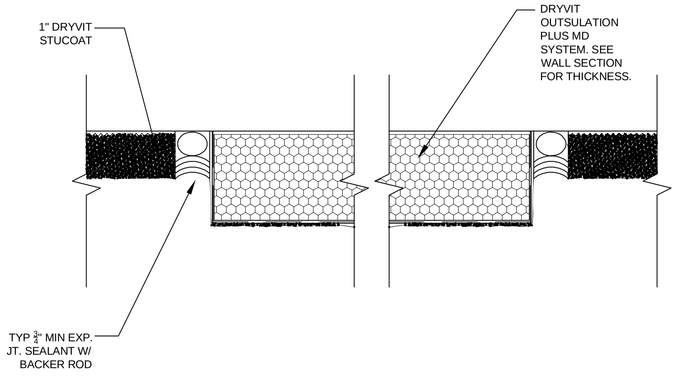

NOT USED
30 DETAIL
SCALE: N.T.S

NOTE: SEE DRYVIT TYP EXP JT DETAIL ON A7.0 FOR FURTHER NOTES

STUCOAT & EIFS TRANSITION
26 DETAIL
SCALE: N.T.S

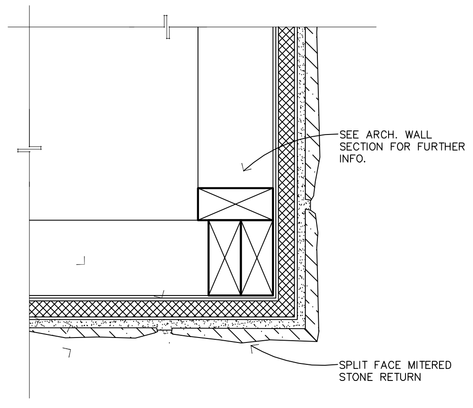

CORNER WITH STONE
22 DETAIL
SCALE: N.T.S

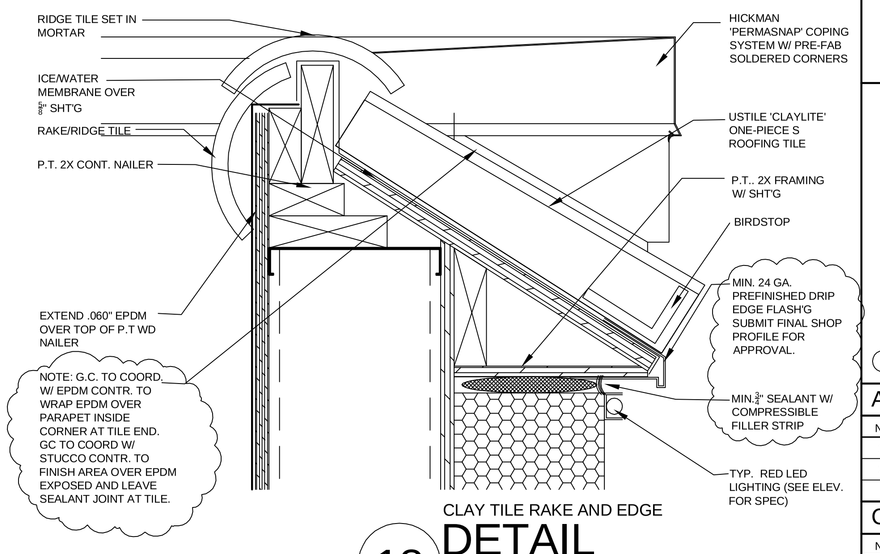

CLAY TILE RAKE AND EDGE
18 DETAIL
SCALE: 3" = 1'-0"

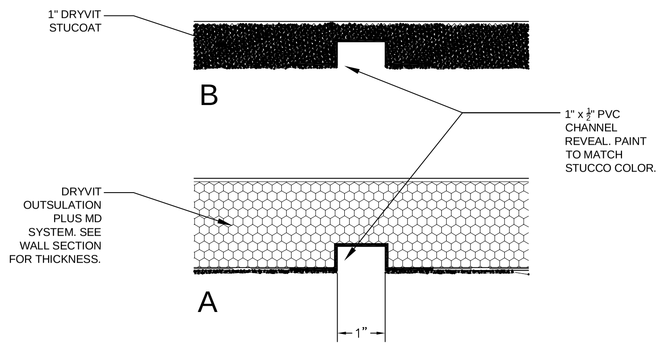

NOT USED
29 DETAIL
SCALE: N.T.S

PVC CHANNEL REVEAL
25 DETAIL
SCALE: N.T.S

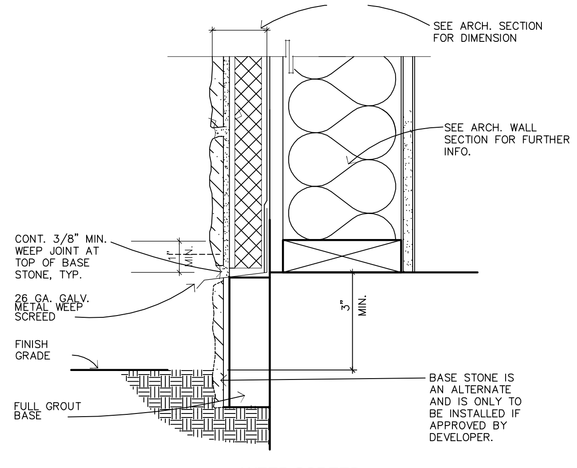

WEEP SCREED
21 DETAIL
SCALE: N.T.S

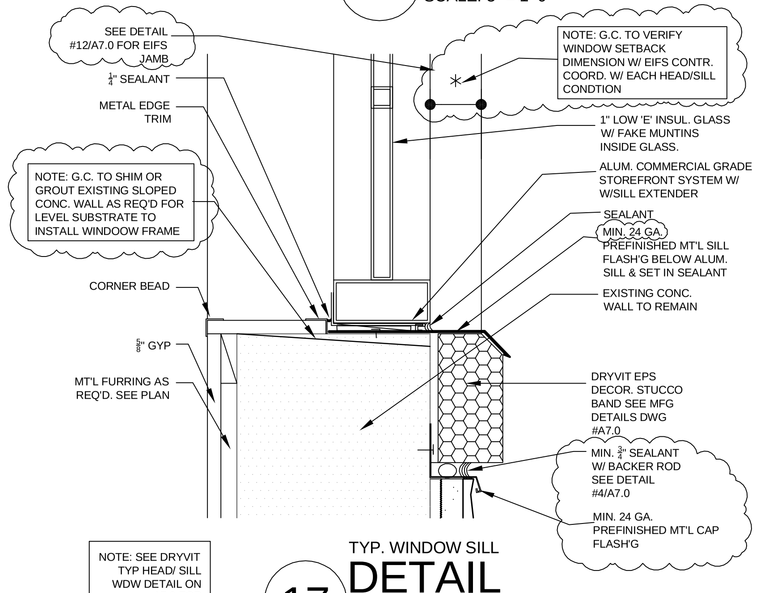

NOTE: SEE DRYVIT TYP HEAD/ SILL WDW DETAIL ON A7.0 FOR FURTHER NOTES

TYP. WINDOW SILL
17 DETAIL
SCALE: 3" = 1'-0"

vocon.
3142 PROSPECT AVENUE
CLEVELAND, OH
44115 - 2612

T 216 . 588 . 0800
866 . 787 . 7021
F 216 . 588 . 0801
E vocon@vocon.com

WORKLEY Architects, Inc
D/B/A
vocon. architecture

THORSON BAKER & Associates, Inc.
3030 West Streetsboro Road
Richfield, Ohio 44286
Consulting Engineers
(330) 659-6688 Ph.
(330) 659-6675 Fax

GROUP MACKENZIE
Civil Engineering
Structural Engineering
Transportation Planning
Landscape Architecture
Portland OR 503.224.9560
Vancouver WA 360.695.7879
Architecture
Interior Design
Land Use Planning
Seattle WA 206.749.9993

PROFESSIONAL SEAL:
I hereby certify that this drawing, plan, specification, or report was prepared by me or under my direct supervision and that I am a duly registered Architect (or Engineer, respectively) under the laws of the State of which govern this project.
WARNING: per LAW No person may alter these documents unless person is, "or under the direct supervision of " the licensed architect (or Engineer, respectively). [including all copyrights]
Date:
Registration No:

PROPOSED EXTERIOR & INTERIOR RENOVATION FOR:

KeyBank National Association
Hollywood Branch
3839 NE Broadway
Portland, OR 97232

KEY PLAN
SCALE: N.T.S.

APPROVAL:

No.	Date	Description
1	MAR. 23, 2009	DESIGN REVIEW RESUBMITTAL
2	JULY 2, 2009	100% PERMIT SET

CD, REVISIONS:

No.	Date	Description
1	Aug. 14, 2009	Plan Review Revisions
2	Sept. 25, 2009	Addendum/Bulletin #1
3	Jan. 11, 2010	Bulletin #2
4	Jan. 13, 2010	Bulletin #3
5	Jan. 21, 2010	Bulletin #4

DRAWN BY: MJK
CHECKED BY: MJK
JOB NUMBER: 6262.00

DRAWING PHASE:

SHEET TITLE:
EXTERIOR DETAILS

SHEET NUMBER:
A7.1